

STATE ENGINEER  
Salem, Oregon


Well Record LANE ESTATE WELL NO. 17/4W-13E(2)  
COUNTY Lane  
12005 APPLICATION NO. GR-377

OWNER: James D. Brown MAILING ADDRESS: 120 Owasso Drive

LOCATION OF WELL: Owner's No. 1 CITY AND STATE: Eugene, Oregon

SW  $\frac{1}{4}$  NW  $\frac{1}{4}$  Sec. 13 T. 17 N. S., R. 4 E. W., W.M.

Bearing and distance from section or subdivision corner 3907.5 ft. S. 89° 45' E. from SW cor.  
Joseph Davis DLG 48

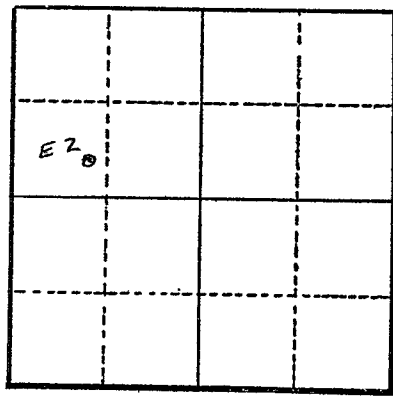

Altitude at well 390 ft.

TYPE OF WELL: driven Date Constructed July 1937

Depth drilled 20 ft. Depth cased None

Section 13

CASING RECORD: 2 inch

FINISH:

AQUIFERS:

WATER LEVEL: 6 to 10 ft.

PUMPING EQUIPMENT: Type centrifugal H.P. 5  
Capacity 100 G.P.M.

WELL TESTS:  
Drawdown ..... ft. after ..... hours ..... G.P.M.  
Drawdown ..... ft. after ..... hours ..... G.P.M.

USE OF WATER irrigation 31 acres Temp. ..... °F. ...., 19

SOURCE OF INFORMATION GR-377

DRILLER or DIGGER .....

ADDITIONAL DATA:  
Log ..... Water Level Measurements ..... Chemical Analysis ..... Aquifer Test .....

REMARKS: