


STATE ENGINEER  
Salem, Oregon

Well Record <sup>LANE</sup> STATE WELL NO. 17/4W-13F(1)  
12010 COUNTY Lane  
APPLICATION NO. GR-377

OWNER: James D. Brown MAILING ADDRESS: 120 Owasso Drive

LOCATION OF WELL: Owner's No. 3 CITY AND STATE: Eugene, Oregon

SE 1/4 NW 1/4 Sec. 13 T. 17 N. S. R. 4 W., W.M.  
Bearing and distance from section or subdivision  
corner 4621.1 ft. S. 84° 43' E. from SW cor.  
Joseph Davis DIC 48

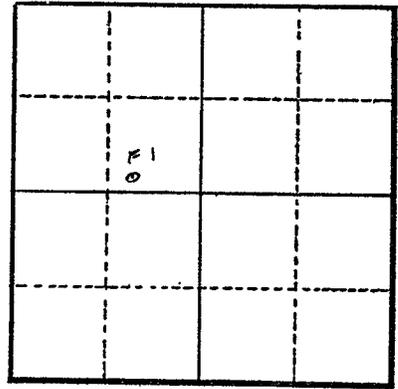

Altitude at well 390 ft.

TYPE OF WELL: driven Date Constructed June 1947

Depth drilled 20 ft. Depth cased none

Section 13

CASING RECORD:

FINISH:

AQUIFERS:

WATER LEVEL: 6 - 10 ft.

PUMPING EQUIPMENT: Type centrifugal H.P. 5  
Capacity 120 G.P.M.

WELL TESTS:  
Drawdown ft. after hours G.P.M.  
Drawdown ft. after hours G.P.M.

USE OF WATER irrigation 31 acres Temp. °F. 19

SOURCE OF INFORMATION GR-377

DRILLER or DIGGER D. D. Dickenson, Eugene, Oregon

ADDITIONAL DATA:  
Log Water Level Measurements Chemical Analysis Aquifer Test

REMARKS: