

STATE ENGINEER
Salem, Oregon

Well Record **LANE** STATE WELL NO. 17/4W-13E(3)
COUNTY Lane
APPLICATION NO. GR-547

OWNER: City of Eugene


MAILING ADDRESS: City Recorder

LOCATION OF WELL: Owner's No. 2

CITY AND STATE: Eugene, Oregon

SE 1/4 NW 1/4 Sec. 13 T. 17 N. S. R. 4 W., W.M.

Bearing and distance from section or subdivision corner 881.28 ft. N. & 2251.12 ft. E. of 1/4 cor. between Sec's 13 & 14

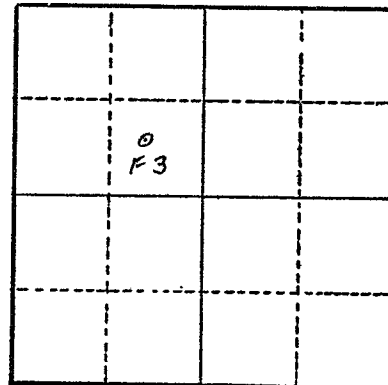

Section 13

Altitude at well 397.7

TYPE OF WELL: drilled Date Constructed Sept. 1953

Depth drilled 26 ft. Depth cased 26 ft.

CASING RECORD: 24 inch concrete

FINISH:

AQUIFERS:

WATER LEVEL: 10 - 11 ft.

PUMPING EQUIPMENT: Type two Berkeley Deep well jets H.P. 1.5 & 3
Capacity 15 & 40 G.P.M.

WELL TESTS:
Drawdown ft. after hours G.P.M.
Drawdown ft. after hours G.P.M.

USE OF WATER municipal - Sewage Disposal plant Temp. °F. 19

SOURCE OF INFORMATION GR-547

DRILLER or DIGGER

ADDITIONAL DATA:
Log Water Level Measurements Chemical Analysis Aquifer Test

REMARKS: Log: Sandy silt 0 to 6 - 8 ft.
Waterbearing gravel 6 - 8 to 20 ft.