

STATE ENGINEER
Salem, Oregon

Well Record

LANE
12025
STATE WELL NO. 17/4W-13F(2)
COUNTY Lane
APPLICATION NO. GR-546

OWNER: City of Eugene

MAILING

ADDRESS: City Recorder

LOCATION OF WELL: Owner's No. 1


CITY AND

STATE: Eugene, Oregon

SE 1/4 NW 1/4 Sec. 13 T. 17 N. S. R. 4 W., W.M.

Bearing and distance from section or subdivision

corner 1113.28 ft. N. & 2203.12 ft. E. of W¹/₄ cor.
Sec. 13

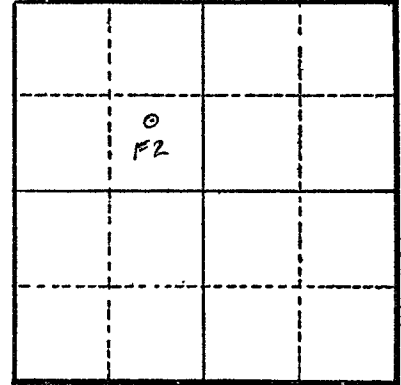

Section 13

Altitude at well 396 ft.

TYPE OF WELL: drilled Date Constructed Sept. 1953

Depth drilled 20 ft. Depth cased 20 ft.

CASING RECORD: 48 inch concrete

FINISH:

AQUIFERS:

WATER LEVEL: 10 - 12 ft.

PUMPING EQUIPMENT: Type two Berkeley turbines H.P. 3 & 20
Capacity G.P.M.

WELL TESTS:

Drawdown ft. after hours G.P.M.

Drawdown ft. after hours G.P.M.

USE OF WATER municipal - sewage disposal plant Temp. °F. 19

SOURCE OF INFORMATION GR-546

DRILLER or DIGGER

ADDITIONAL DATA:

Log Water Level Measurements Chemical Analysis Aquifer Test

REMARKS: Log: Sandy silt 0 to 6 or 8 ft.
Waterbearing gravel 6 or 8 to 20 ft.