

STATE ENGINEER
Salem, Oregon

Well Record **LANE** STATE WELL NO. 17/4W-13P
COUNTY LANE
12039 APPLICATION NO. GR-2372

OWNER: James B. Chapman


MAILING ADDRESS: 51 Chapman Dr.

LOCATION OF WELL: Owner's No. _____

CITY AND STATE: Eugene, Oregon

SE 1/4 SW 1/4 Sec. 13 T. 17 N S., R. 4 E W., W.M.

Bearing and distance from section or subdivision corner 22.8 ch. S. & 22.6 ch. E.

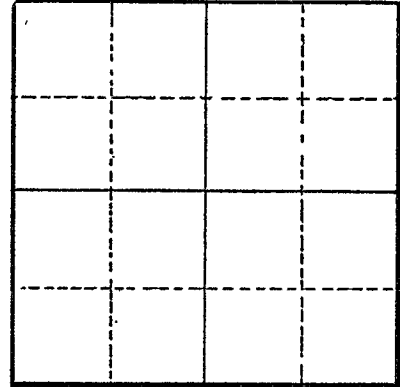

Section _____

Altitude at well _____

TYPE OF WELL: Driven Date Constructed 1943

Depth drilled 22 Depth cased 22

CASING RECORD:

2-2"

FINISH:

Yes but dosen't know how many or depth.

AQUIFERS:

WATER LEVEL:

12-feet

PUMPING EQUIPMENT: Type Fairbanks Morse Centrifugal H.P. 7 1/2
Capacity 180 G.P.M.

WELL TESTS:

Drawdown _____ ft. after _____ hours _____ G.P.M.

Drawdown _____ ft. after _____ hours _____ G.P.M.

USE OF WATER Irrigation Temp. _____ °F. _____, 19____

SOURCE OF INFORMATION GR-2253

DRILLER or DIGGER D. D. Dickenson, Eugene, Oregon

ADDITIONAL DATA:

Log _____ Water Level Measurements _____ Chemical Analysis _____ Aquifer Test _____

REMARKS: