

STATE ENGINEER
Salem, Oregon

Well Record

STATE WELL NO. 17/4W-13R
COUNTY Lane
APPLICATION NO. GR-3897

12036

OWNER: Glenn H. & Lucille E. Haney


MAILING ADDRESS: 1445 Goodpasture Rd.

LOCATION OF WELL: Owner's No.

CITY AND STATE: Eugene, Oregon

SE 1/4 SE 1/4 Sec. 13 T. 17 S., R. 4 W., W.M.

Bearing and distance from section or subdivision corner 1080' W. & 400' N. SE Cor. Sec. 13

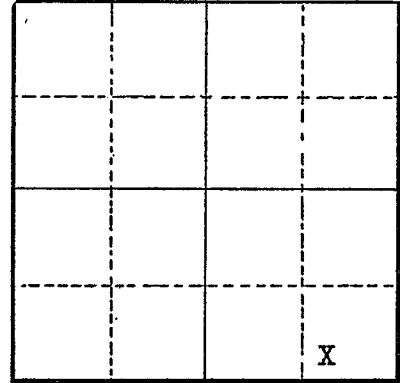

Altitude at well

TYPE OF WELL: Driven Date Constructed July, 1951

Depth drilled 25 ft. Depth cased

Section 13

CASING RECORD:

FINISH:

AQUIFERS:

WATER LEVEL:

12 feet below surface

PUMPING EQUIPMENT: Type Fairbanks Morse H.P. 5
Capacity 80 G.P.M.

WELL TESTS:

Drawdown ft. after hours G.P.M.
Drawdown ft. after hours G.P.M.

USE OF WATER Irrigation Temp. °F., 19

SOURCE OF INFORMATION Well Registration Statement Cert. # GR-3540

DRILLER or DIGGER

ADDITIONAL DATA:

Log Water Level Measurements Chemical Analysis Aquifer Test

REMARKS: