

STATE ENGINEER
Salem, Oregon

Well Record

STATE WELL NO. 17/AM-13R

COUNTY Lane

APPLICATION NO. GR-1370

GR- 1328

LANE
12037

OWNER: Frank R. Kingsley

MAILING ADDRESS: 1300 Goodpasture Rd.


LOCATION OF WELL: Owner's No.

CITY AND STATE: Eugene, Oregon

SE 1/4 SE 1/4 Sec. 13 T. 17 S., R. 4 W., W.M.

Bearing and distance from section or subdivision

corner 1065' E. & 1148.8' S. from SW cor. DIC #58

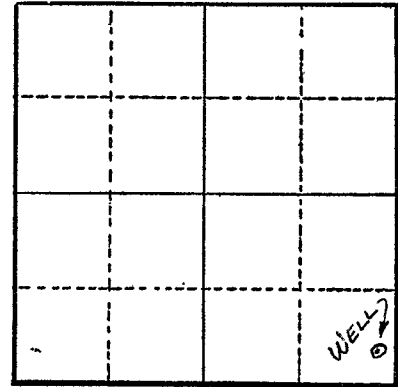

Section 13

Altitude at well 410 ft.

TYPE OF WELL: Driven Date Constructed 1947

Depth drilled 23 ft. Depth cased 23 ft.

CASING RECORD:

3 - 2 in. pipes connected

FINISH:

AQUIFERS:

WATER LEVEL:

10 ft.

PUMPING EQUIPMENT: Type Deming 2 in.

H.P. 7 1/2

Capacity 200 G.P.M.

WELL TESTS:

Drawdown 2 ft. after 200 hours G.P.M.

Drawdown ft. after hours G.P.M.

USE OF WATER Irrigation Temp. °F., 19

SOURCE OF INFORMATION G. R. Record

DRILLER or DIGGER

ADDITIONAL DATA:

Log N.A. Water Level Measurements Chemical Analysis Aquifer Test

REMARKS:

Irrigation of 17 acres.