

STATE ENGINEER  
Salem, Oregon

Well Record **LANE** STATE WELL NO. 17/4W-13R  
12039 COUNTY Lane APPLICATION NO. GR-1363

GR- 1321

OWNER: Dale M. Kingsley

MAILING ADDRESS: 1295 Goodpasture Rd.


LOCATION OF WELL: Owner's No.

CITY AND STATE: Eugene, Oregon

SE 1/4 SE 1/4 Sec. 13 T. 17 S., R. 4 W., W.M.

Bearing and distance from section or subdivision

corner 629.7' S. & 406.5' E. from SW cor. DIC #58

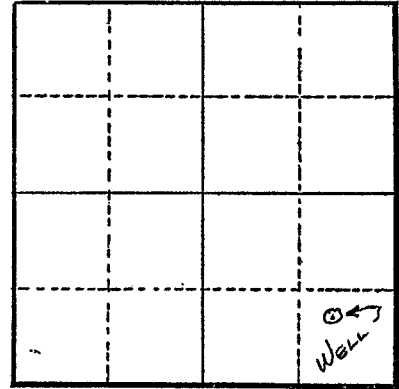

Altitude at well 410 ft.

TYPE OF WELL: Driven Date Constructed 1953

Depth drilled 25 ft. Depth cased 25 ft.

Section 13

CASING RECORD:

4 inch

FINISH:

AQUIFERS:

WATER LEVEL:

10 ft.

PUMPING EQUIPMENT: Type Berkeley 2 1/2 in. Cent. H.P. 10  
Capacity 300 G.P.M.

WELL TESTS:

Drawdown 2 ft. after 300 hours G.P.M.

Drawdown ft. after hours G.P.M.

USE OF WATER Irrigation Temp. °F., 19

SOURCE OF INFORMATION G. R. Record

DRILLER or DIGGER

ADDITIONAL DATA:

Log N.A. Water Level Measurements Chemical Analysis Aquifer Test

REMARKS:

Irrigation of 19.67 acres.