

STATE ENGINEER  
Salem, Oregon


Well Record **LANE** STATE WELL NO. 17/4W-14A(1)  
12068 COUNTY Lane  
APPLICATION NO. GR-508

OWNER: William Bryan Terpening MAILING ADDRESS: 2300 River Rd.

LOCATION OF WELL: Owner's No. CITY AND STATE: Eugene, Oregon

NE 1/4 NE 1/4 Sec. 14 T. 17 N. S., R. 4 E. W., W.M.

Bearing and distance from section or subdivision corner 680 ft. W. & 590 ft. S. NE cor. Sec. 14

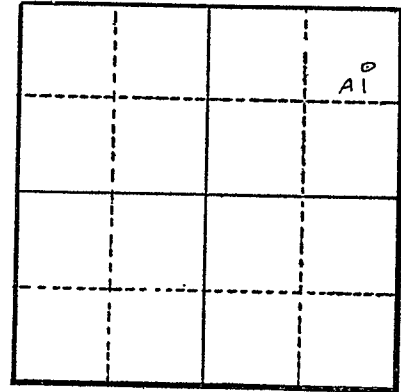

Section 14

Altitude at well 385 ft.

TYPE OF WELL: driven Date Constructed 4/30/45

Depth drilled 20 ft. Depth cased 20 ft.

CASING RECORD: 2 inch

FINISH:

AQUIFERS:

WATER LEVEL: 8 ft.

PUMPING EQUIPMENT: Type Berkeley H.P. 5  
Capacity 120 G.P.M.

WELL TESTS:  
Drawdown 2 ft. after \_\_\_\_\_ hours 120 G.P.M.  
Drawdown \_\_\_\_\_ ft. after \_\_\_\_\_ hours \_\_\_\_\_ G.P.M.

USE OF WATER irrigation 10 acres Temp. \_\_\_\_\_ °F. \_\_\_\_\_, 19\_\_\_\_

SOURCE OF INFORMATION GR-508

DRILLER or DIGGER D. D. Dickelson; 1280 River Road

ADDITIONAL DATA:

Log  Water Level Measurements \_\_\_\_\_ Chemical Analysis \_\_\_\_\_ Aquifer Test \_\_\_\_\_

REMARKS: Log: Loam 0 to 8 ft.  
Coarse gravel 8 to 20 ft.