

STATE ENGINEER  
Salem, Oregon

Well Record **LANE** STATE WELL NO. **17/4W-15L**  
COUNTY **LANE**  
**12/50** APPLICATION NO. **GR-2921**

OWNER: **Willis Glenn**


MAILING ADDRESS: **Rt. 1, Box 694**

LOCATION OF WELL: Owner's No. \_\_\_\_\_

CITY AND STATE: **Eugene, Oregon**

**NE**  $\frac{1}{4}$  **SW**  $\frac{1}{4}$  Sec. **15** T. **17** **N.** **4** **E.**  
S., R. W., W.M.

Bearing and distance from section or subdivision  
corner **2310' E. and 1450' N.**

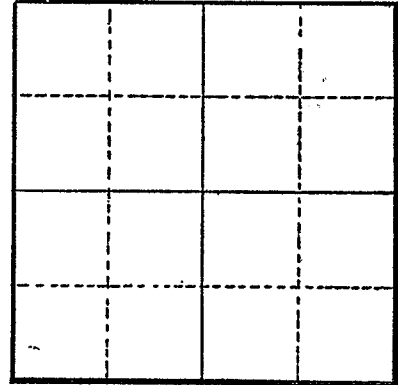

Section \_\_\_\_\_

Altitude at well \_\_\_\_\_

TYPE OF WELL: **driven** Date Constructed **1936**

Depth drilled **20** Depth cased **20**

CASING RECORD:

**1 1/2-inch**

FINISH:

AQUIFERS:

WATER LEVEL:  
**12-feet**

PUMPING EQUIPMENT: Type **Berkeley Centrifugal** H.P. **1**  
Capacity **60** G.P.M.

WELL TESTS:

Drawdown \_\_\_\_\_ ft. after \_\_\_\_\_ hours \_\_\_\_\_ G.P.M.

Drawdown \_\_\_\_\_ ft. after \_\_\_\_\_ hours \_\_\_\_\_ G.P.M.

USE OF WATER **irrigation** Temp. \_\_\_\_\_ °F., 19 \_\_\_\_\_

SOURCE OF INFORMATION **GR-2751**

DRILLER or DIGGER \_\_\_\_\_

ADDITIONAL DATA:

Log \_\_\_\_\_ Water Level Measurements \_\_\_\_\_ Chemical Analysis \_\_\_\_\_ Aquifer Test \_\_\_\_\_

REMARKS: