

STATE ENGINEER
Salem, Oregon

Well Record **LANE** STATE WELL NO. **17/LW-15N(±)**
COUNTY Lane
APPLICATION NO. **GR-578**

22
12/53

OWNER: Glenn Gotcher


MAILING ADDRESS: 651 Bushnell Lane

LOCATION OF WELL: Owner's No.

CITY AND STATE: Eugene, Oregon

SW 1/4 SW 1/4 Sec. 15 T. 17 ^{N.} S., R. 4 ^{E.} W., W.M.

Bearing and distance from section or subdivision
corner 500 ft. N. & 500 ft. E. SW cor. Sec. 15

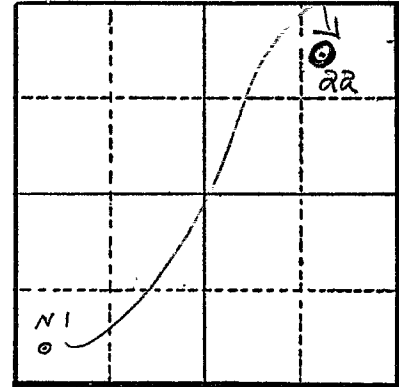

Altitude at well 383 ft.

TYPE OF WELL: drilled Date Constructed 1952

Depth drilled 24 Depth cased

Section 15

CASING RECORD: 5 inch

FINISH:

AQUIFERS:

WATER LEVEL: 15 ft.

PUMPING EQUIPMENT: Type Cornell Centrifugal H.P. 5
Capacity 130 G.P.M.

WELL TESTS:

Drawdown ft. after hours G.P.M.
Drawdown ft. after hours G.P.M.

USE OF WATER irrigation 8 acres Temp. °F., 19

SOURCE OF INFORMATION GR-578

DRILLER or DIGGER Carter; Springfield, Oregon

ADDITIONAL DATA:

Log Water Level Measurements Chemical Analysis Aquifer Test

REMARKS: