

STATE ENGINEER
Salem, Oregon


Well Record **LANE** STATE WELL NO. 17/4W-18A
COUNTY Lane
GR 1607 **12208** APPLICATION NO. GR 1644

OWNER: Earl W. Ringsdorf MAILING ADDRESS: Rt. 1, Box 639

LOCATION OF WELL: Owner's No. CITY AND STATE: Eugene, Oregon

NE 1/4 NE 1/4 Sec. 18 T. 17 S., R. 4 W., W.M.

Bearing and distance from section or subdivision corner 450' S. 33°W. from NE cor. Sec. 18

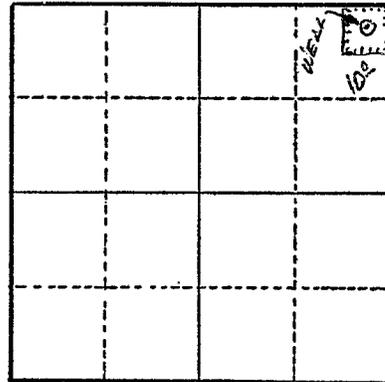

Section 18

Altitude at well 350'

TYPE OF WELL: Drilled Date Constructed 1953

Depth drilled 31' Depth cased 31'

CASING RECORD:
5"

FINISH:

AQUIFERS:

WATER LEVEL:
18'

PUMPING EQUIPMENT: Type F. M. 1 1/2" Cent. H.P. 1
Capacity 30 G.P.M.

WELL TESTS:
Drawdown ft. after hours G.P.M.
Drawdown ft. after hours G.P.M.

USE OF WATER Irrigation Temp. °F., 19

SOURCE OF INFORMATION GR Record

DRILLER or DIGGER Wayne Hayes

ADDITIONAL DATA:
Log N.A. Water Level Measurements Chemical Analysis Aquifer Test

REMARKS:

Irrigation of 10 acres.