

STATE ENGINEER  
Salem, Oregon

# Well Record

STATE WELL NO. 17/4W-18L  
COUNTY LANE  
APPLICATION NO. GR-2523

OWNER: James R. Wobbe

MAILING

ADDRESS: Rt. 1, Box 260

LOCATION OF WELL: Owner's No. #2


CITY AND

STATE: Eugene, Oregon

NE 1/4 SW 1/4 Sec. 18 T. 17 S. R. 4 W., W.M.

Bearing and distance from section or subdivision

corner 1280' W. and 140' S.

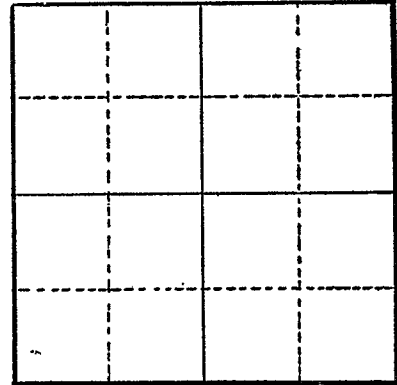

Section

Altitude at well

TYPE OF WELL: Dug Date Constructed 1952

Depth drilled 60 Depth cased 60

## CASING RECORD:

5-inch

## FINISH:

4' of standard perforated casing from 16 to 20

## AQUIFERS:

Clay, loam, rock, sand and gravel

## WATER LEVEL:

5-feet

PUMPING EQUIPMENT: Type Jacuzzi Jet H.P. 1  
Capacity 30 G.P.M.

## WELL TESTS:

Drawdown 10 ft. after hours Pumping 50 G.P.M.

Drawdown ft. after hours G.P.M.

USE OF WATER Irrigation Temp. °F. 19

SOURCE OF INFORMATION GR-2386

DRILLER or DIGGER

## ADDITIONAL DATA:

Log X Water Level Measurements Chemical Analysis Aquifer Test

## REMARKS:

Clay loam	2	2
Black clay	1	3
Clay with embedded rock & layers of sand	47	50
Gravel	10	60