

STATE ENGINEER
Salem, Oregon

Well Record LANE

STATE WELL NO. 17/4W-24D
COUNTY LANE
APPLICATION NO. GR-2182

OWNER: Roy S. Woodruff


MAILING ADDRESS: 1270 River Road

LOCATION OF WELL: Owner's No. _____

CITY AND STATE: Eugene, Oregon

Nw 1/4 Nw 1/4 Sec. 24 T. 17 S., R. 4 W., W.M.

Bearing and distance from section or subdivision
corner 3 miles from Courthouse at Eugene
332' W and 90'S of NE corner above property
described

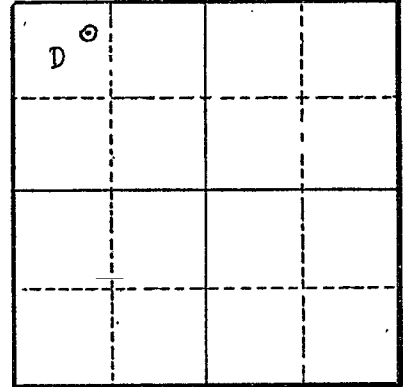

Section 24

Altitude at well _____

TYPE OF WELL: Dug; drilled Date Constructed 1921

Depth drilled 26' Depth cased 26'

CASING RECORD:

3-inch

FINISH:

24 perft - 3/8 inch perforations 3 inches apart

AQUIFERS:

soil clay; brown silt; river bed gravel

WATER LEVEL:

15 1/4'

PUMPING EQUIPMENT: Type Fairbanks-Morse centrifugal

H.P. 7 1/2

Capacity 100 G.P.M.

WELL TESTS:

Drawdown none ft. after _____ hours 100 G.P.M.

Drawdown _____ ft. after _____ hours _____ G.P.M.

USE OF WATER Irrigation Temp. _____ °F. _____, 19_____

SOURCE OF INFORMATION GR-3859

DRILLER or DIGGER NA

ADDITIONAL DATA:

Log Water Level Measurements _____ Chemical Analysis _____ Aquifer Test _____

REMARKS:

Top soil clay loam 2 1/2
Brown silt loam 4 1/2
River Bed gravel 19 to 26