

STATE ENGINEER
Salem, Oregon

Well Record

LANE STATE WELL NO. 17/101-24A
COUNTY Lane
APPLICATION NO. GR-1335

GR- 1290

OWNER: C. J. Sylvester

MAILING ADDRESS: 1520 Goodpasture Rd.


LOCATION OF WELL: Owner's No. #1

CITY AND STATE: Eugene, Oregon

NE 1/4 NE 1/4 Sec. 24 T. 17 N. S. R. 4 W., W.M.

Bearing and distance from section or subdivision

corner 350' W. & 120' S. of NE cor. Sec. 24

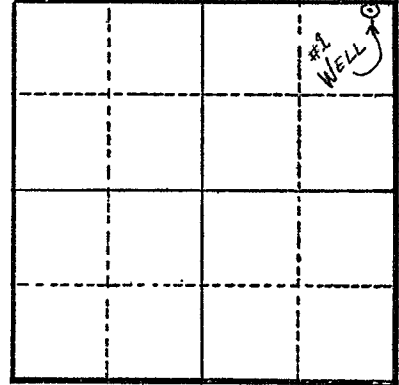

Section 24

Altitude at well

TYPE OF WELL: Drl. & Drn. Date Constructed 1935

Depth drilled 30' & 46' Depth cased 30' & 46'

CASING RECORD:

Drilled: 1 well is cased with 4 in. from 0 to 46 ft.)
Driven : 3 wells are cased with 1 1/2 in. from 0 to 30 ft.) -- Each 20' apart & manifolded.

FINISH:

The driven wells are shot with dynamite

The drilled well is perforated with torch slots 1/2 x 4 in. (5/ft.) from 42 to 46 ft.

AQUIFERS:

WATER LEVEL:

17 ft.

PUMPING EQUIPMENT: Type Rain-O-Flow 2 in. Cent. H.P. 7 1/2
Capacity 200 G.P.M.

WELL TESTS:

Drawdown ft. after hours G.P.M.

Drawdown ft. after hours G.P.M.

USE OF WATER Irrigation Temp. °F. 19

SOURCE OF INFORMATION G. R. Record

DRILLER or DIGGER

ADDITIONAL DATA:

Log N.A. Water Level Measurements Chemical Analysis Aquifer Test

REMARKS:

Irrigation of 20 acres.