

STATE ENGINEER
Salem, Oregon

Well Record LANE

STATE WELL NO. 17/4W-24G
COUNTY Lane
APPLICATION NO. GR-2923

12374

OWNER: Edward L. Peltier


MAILING ADDRESS: 130 E. Hilliard Lane

LOCATION OF WELL: Owner's No. _____

CITY AND STATE: Eugene, Oregon

SW 1/4 NE 1/4 Sec. 24 T. 17 S., R. 4 N. E. W.M.

Bearing and distance from section or subdivision corner 2050 feet West and 400 feet North from the E 1/4 Corner.

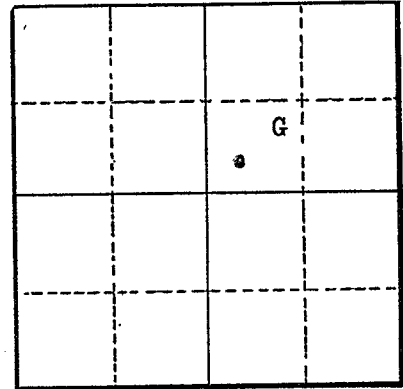

Altitude at well 380 feet

TYPE OF WELL: Driven Date Constructed May 1954

Depth drilled 20 feet Depth cased 20 feet

Section 24

CASING RECORD:

1 1/2 inch casing set from 0 to 20 feet

FINISH: Blacksmith

well point with 80 3/8 holes spaced for a 3 foot distance up from point

AQUIFERS:

Driven thru sand and gravel 18 to 20 feet

WATER LEVEL:

15 feet

PUMPING EQUIPMENT: Type 2 stage Centrifugal-Universal H.P. _____

Capacity 75 G.P.M.

WELL TESTS:

Drawdown 2 ft. after _____ hours 35 G.P.M.

Drawdown _____ ft. after _____ hours _____ G.P.M.

USE OF WATER Irrigation Temp. _____ °F. _____, 19____

SOURCE OF INFORMATION GR-4076

DRILLER or DIGGER _____

ADDITIONAL DATA:

Log (NA) Water Level Measurements _____ Chemical Analysis _____ Aquifer Test _____

REMARKS: