

STATE ENGINEER
Salem, Oregon

Well Record

LANE STATE WELL NO. 17/4W-25G
COUNTY LANE
APPLICATION NO. GR-3322

OWNER: E. J. Loucks


MAILING ADDRESS: 111 thomason St

LOCATION OF WELL: Owner's No.

CITY AND STATE: Eugene, Oregon

SW 1/4 NE 1/4 Sec. 25 T. 17 S., R. 4 W., W.M.

Bearing and distance from section or subdivision corner 346.4' E of a point on E line of County Rd. No. 200
1680' S 2010' W from NE cor Sec 25.

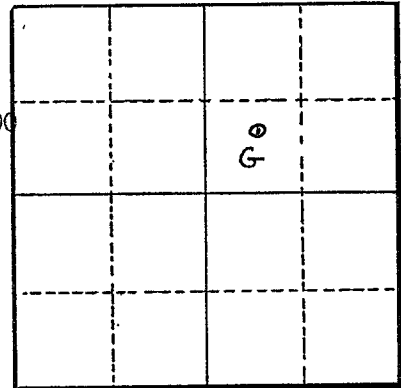

Section 25

Altitude at well

TYPE OF WELL: Dug Date Constructed 1930

Depth drilled 19' Depth cased 30'

CASING RECORD:

30-inch

FINISH:

AQUIFERS: heavy loam, loose loam, loose water gravel & sand

WATER LEVEL:

4 1/2'

PUMPING EQUIPMENT: Type Deming Centrifugal H.P. 1

Capacity 16 2/3 G.P.M.

WELL TESTS:

Drawdown 1 1/2 ft. after 1500 hours G.P.M.

Drawdown ft. after hours G.P.M.

USE OF WATER Irrigation Temp. °F., 19

SOURCE OF INFORMATION GR-3918

DRILLER or DIGGER

ADDITIONAL DATA:

Log Water Level Measurements Chemical Analysis Aquifer Test

REMARKS:

heavy loam 3'
loose loam 4'
loose water & sand 12'