

STATE ENGINEER
Salem, Oregon

Well Record **LANE** STATE WELL NO. 17/LW-28D
12458 COUNTY Lane
APPLICATION NO. GR-3347

OWNER: Eugene L. Mikkelsen for LeRay L. Mikkelsen

MAILING ADDRESS: Box 353 Royal Ave.


LOCATION OF WELL: Owner's No.

CITY AND STATE: Eugene, Oregon

NW 1/4 NW 1/4 Sec. 28 T. 17 N. S. R. 4 W., W.M.

Bearing and distance from section or subdivision

corner 198' S. and 494' E.

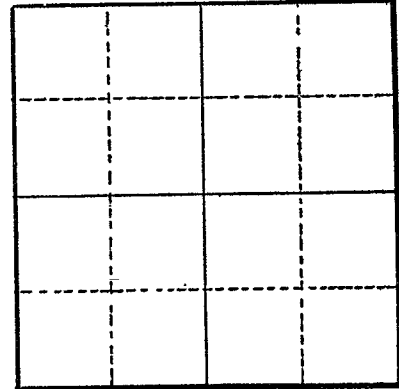

Section

Altitude at well

TYPE OF WELL: drilled Date Constructed 1948

Depth drilled 150' Depth cased 150'

CASING RECORD:

6"

FINISH:

AQUIFERS:

WATER LEVEL:

14'

PUMPING EQUIPMENT: Type Fairbanks Morse H.P. 5
Capacity 125 G.P.M.

WELL TESTS:

Drawdown ft. after hours G.P.M.
Drawdown ft. after hours G.P.M.

USE OF WATER Irrigation Temp. °F., 19

SOURCE OF INFORMATION GR-3099

DRILLER or DIGGER Ding Springfield

ADDITIONAL DATA:

Log Water Level Measurements Chemical Analysis Aquifer Test

REMARKS: