

STATE ENGINEER  
Salem, Oregon

Well Record **LANE** STATE WELL NO. 17/4W-28F  
COUNTY Lane  
APPLICATION NO. GR-4255

OWNER: Blue River Farms


MAILING ADDRESS: Route 5, Box 164

LOCATION OF WELL: Owner's No. \_\_\_\_\_

CITY AND STATE: Eugene, Oregon

SE  $\frac{1}{4}$  NW  $\frac{1}{4}$  Sec. 28 T. 17 N. S., R. 4 E. W., W.M.

Bearing and distance from section or subdivision  
corner 2050' S. & 530' W. of N $\frac{1}{4}$  Cor. Sec. 28

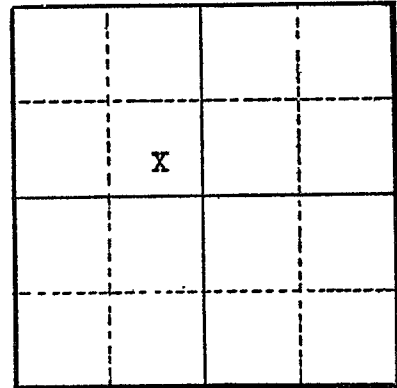

Altitude at well \_\_\_\_\_

TYPE OF WELL: Dug gravel pit Date Constructed 2/36

Depth drilled 20 ft. Depth cased \_\_\_\_\_

Section 28

CASING RECORD:

FINISH:

AQUIFERS:

WATER LEVEL:

8 feet below surface

PUMPING EQUIPMENT: Type Fairbanks Morse centrifugal H.P. 10  
Capacity 336 G.P.M.

WELL TESTS:

Drawdown \_\_\_\_\_ ft. after \_\_\_\_\_ hours \_\_\_\_\_ G.P.M.  
Drawdown \_\_\_\_\_ ft. after \_\_\_\_\_ hours \_\_\_\_\_ G.P.M.

USE OF WATER Irrigation Temp. \_\_\_\_\_ °F., 19 \_\_\_\_\_

SOURCE OF INFORMATION Well Registration Statement Cert. # GR-3787

DRILLER or DIGGER \_\_\_\_\_

ADDITIONAL DATA:

Log  Water Level Measurements \_\_\_\_\_ Chemical Analysis \_\_\_\_\_ Aquifer Test \_\_\_\_\_

REMARKS:

Log:	Thickness	Depth to Bottom
Top soil	2	2
Mixture of soil & gravel	6	8
River gravel	12	20