

STATE ENGINEER
Salem, Oregon

Well Record

STATE WELL NO. 17/4W-29R.
COUNTY Lane
APPLICATION NO. GR-3988

LANE
12/10

OWNER: Clair J. Deertz


MAILING ADDRESS: RFD 1, Box 345

LOCATION OF WELL: Owner's No.

CITY AND STATE: Eugene, Oregon

SE 1/4 SE 1/4 Sec. 29 T. 17 N. S, R. 4 E W, W.M.

Bearing and distance from section or subdivision corner

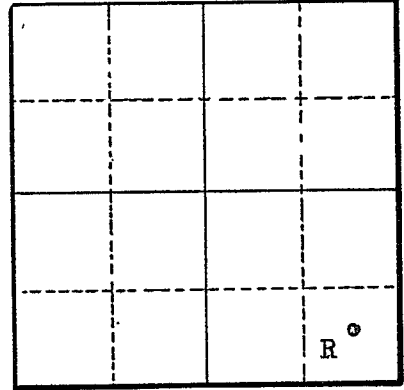

Section 29

Altitude at well 400 feet

TYPE OF WELL: Drilled Date Constructed 1945

Depth drilled 110 feet Depth cased 110 feet

CASING RECORD:

6-inch perforated casing set from 6 to 110 feet

FINISH:

perforated casings 110 feet slotted

AQUIFERS:

WATER LEVEL:

10 feet

PUMPING EQUIPMENT: Type no pump inst. 1955-58 H.P.

Capacity G.P.M.

WELL TESTS:

Drawdown 15 ft. after hours 115 G.P.M.

Drawdown 15 ft. after hours 115 G.P.M.

USE OF WATER Irrigation Temp. °F., 19

SOURCE OF INFORMATION GR-4094

DRILLER or DIGGER Lloyd Gordinier

ADDITIONAL DATA:

Log (NA) Water Level Measurements Chemical Analysis Aquifer Test

REMARKS: