


STATE ENGINEER  
Salem, Oregon

Well Record **LANE** STATE WELL NO. 17/4W-29R  
COUNTY Lane  
APPLICATION NO. G-1578

OWNER: Lichy - Gregory Lumber Co. MAILING ADDRESS: Box 271  
CITY AND STATE: Eugene, Oregon

LOCATION OF WELL: Owner's No. \_\_\_\_\_  
SE 1/4 SE 1/4 Sec. 29 T. 17 N. S. R. 4 E. W., W.M.

Bearing and distance from section or subdivision  
corner 943' N. & 601' W. from SE cor. Sec. 29

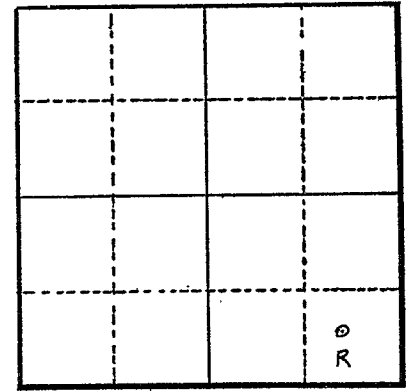

Section 29

Altitude at well \_\_\_\_\_

TYPE OF WELL: drilled Date Constructed 1944

Depth drilled 50 ft. Depth cased 50 ft.

CASING RECORD: 4 inch

FINISH:

AQUIFERS:

WATER LEVEL: 12 reported

PUMPING EQUIPMENT: Type \_\_\_\_\_ H.P. 2  
Capacity 90 G.P.M.

WELL TESTS:  
Drawdown \_\_\_\_\_ ft. after \_\_\_\_\_ hours \_\_\_\_\_ G.P.M.  
Drawdown \_\_\_\_\_ ft. after \_\_\_\_\_ hours \_\_\_\_\_ G.P.M.

USE OF WATER industrial - Log pond Temp. \_\_\_\_\_ °F. \_\_\_\_\_, 19\_\_\_\_

SOURCE OF INFORMATION G-1578

DRILLER or DIGGER \_\_\_\_\_  
ADDITIONAL DATA:  
Log \_\_\_\_\_ Water Level Measurements \_\_\_\_\_ Chemical Analysis \_\_\_\_\_ Aquifer Test \_\_\_\_\_

REMARKS: