

STATE ENGINEER
Salem, Oregon

Well Record **LANE** STATE WELL NO. 17/4W-31J(1)
12565 COUNTY Lane
APPLICATION NO. GR-8

OWNER: Harry Bower

MAILING

ADDRESS: Rt. 5, Box 399

CITY AND


STATE: Eugene, Oregon

LOCATION OF WELL: Owner's No. _____

NE $\frac{1}{4}$ SE $\frac{1}{4}$ Sec. 31 T. 17 N. S. R. 4 E. W., W.M.

Bearing and distance from section or subdivision

corner 660' SW of NE $\frac{1}{4}$ cor. of NE $\frac{1}{4}$ SE $\frac{1}{4}$ Sec. 31

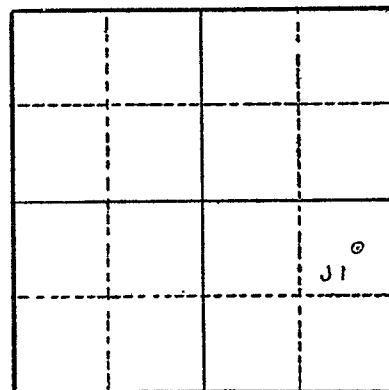

Altitude at well 406 ft. Interpolated

TYPE OF WELL: drilled Date Constructed Sept. 1953

Depth drilled 70' Depth cased 26'

Section 31

CASING RECORD: 6 inch casing set from 0 to 26 ft.

FINISH: none

AQUIFERS: Sandstone 65 to 70 ft.

WATER LEVEL: 18 ft. below land surface September 1955

PUMPING EQUIPMENT: Type Smith Way (Coop) H.P. 3
Capacity 80 G.P.M.

WELL TESTS:
Drawdown 3 ft. after _____ hours 80 G.P.M.
Drawdown _____ ft. after _____ hours _____ G.P.M.

USE OF WATER Irrigation Temp. _____ °F. _____, 19____

SOURCE OF INFORMATION Reg. St. GR-8

DRILLER or DIGGER _____

ADDITIONAL DATA:

Log X Water Level Measurements _____ Chemical Analysis _____ Aquifer Test _____

REMARKS:

State Well No. 17/LW-31J(1)
County Lane
Application No. GR-8

Owner: Harry Bower Owner's No. 1
Driller: _____ Date Drilled September 1953

[illegible]