

STATE ENGINEER
Salem, Oregon

Well Record

STATE WELL NO. 17/4W-32N
COUNTY LANE
APPLICATION NO. GR-2618

OWNER: William T. & Gladys Andrews

MAILING
ADDRESS:

Rt. 5, Box 400-A

LOCATION OF WELL: Owner's No.


CITY AND
STATE:

Eugene, Oregon

SW 1/4 SW 1/4 Sec. 32 T. 17 N. 4 E. W., W.M.

Bearing and distance from section or subdivision

corner 11 chains N. of SW corner of Sec. 32 T. 17 S.,
R. 4 W., W.M. and 250' E. to location of well.

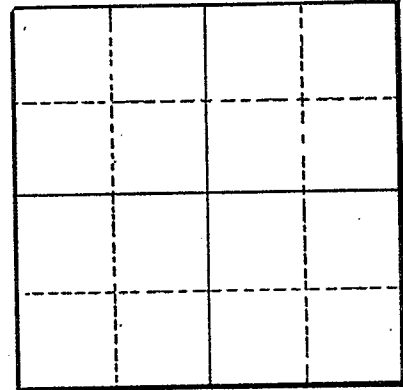

Section

Altitude at well

TYPE OF WELL: Drilled Date Constructed 1955

Depth drilled 85 Depth cased 22

CASING RECORD:

6-inch

FINISH:

AQUIFERS:

WATER LEVEL:

40 to 50-feet

PUMPING EQUIPMENT: Type Berkeley Submersible H.P. 1
Capacity 30 G.P.M.

WELL TESTS:
Drawdown 11 1/2 ft. after hours Pumping 30 G.P.M.
Drawdown ft. after hours G.P.M.

USE OF WATER Irrigation Temp. °F., 19

SOURCE OF INFORMATION GR-2485
DRILLER or DIGGER Mark Christensen, 3550 West 18th, Eugene, Oregon

ADDITIONAL DATA:

Log Water Level Measurements Chemical Analysis Aquifer Test

REMARKS: