


STATE ENGINEER  
Salem, Oregon

Well Record **LANE** STATE WELL NO. 17/4W-33G  
12622 COUNTY Lane  
APPLICATION NO. GR-3696

OWNER: Edward Glanz & Vera K. Glanz MAILING ADDRESS: Route 5, Box 172A  
LOCATION OF WELL: Owner's No. CITY AND STATE: Eugene, Oregon

SW 1/4 NE 1/4 Sec. 33 T. 17 N. S. R. 4 W., W.M.  
Bearing and distance from section or subdivision corner 2540 ft. S. 52° 45' W. from NE cor. Sec. 33

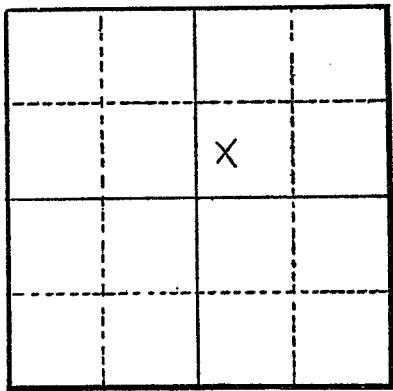

Section 33

Altitude at well

TYPE OF WELL: Drilled Date Constructed 4/20/50  
Depth drilled 65 feet Depth cased 34 feet

CASING RECORD:

6 inch steel casing set to 34 feet

FINISH:

AQUIFERS:

WATER LEVEL:

PUMPING EQUIPMENT: Type Jacuzzi H.P. 3  
Capacity 50 G.P.M.

WELL TESTS:  
Drawdown 40 ft. after 60 hours G.P.M.  
Drawdown ft. after hours G.P.M.

USE OF WATER Irrigation Temp. °F. 19  
SOURCE OF INFORMATION Well Registration Statement

DRILLER or DIGGER Wayne - Hayes

ADDITIONAL DATA:  
Log Water Level Measurements Chemical Analysis Aquifer Test

REMARKS:

385