

STATE ENGINEER  
Salem, Oregon

# Well Record <sup>LANE</sup>


STATE WELL NO. 17/4W-33P  
COUNTY Lane  
APPLICATION NO. GR-4096

OWNER: Frank and Rosetta Bradbury  
MAILING ADDRESS: Route 5, Box 416 **12625**

LOCATION OF WELL: Owner's No. \_\_\_\_\_  
CITY AND STATE: Eugene, Oregon

SE 1/4 SW 1/4 Sec. 33 T. 17 N. S. R. 4 E. W.M.

Bearing and distance from section or subdivision  
corner 1000 feet West and 510 feet North from S 1/4  
Corner, Section 33.

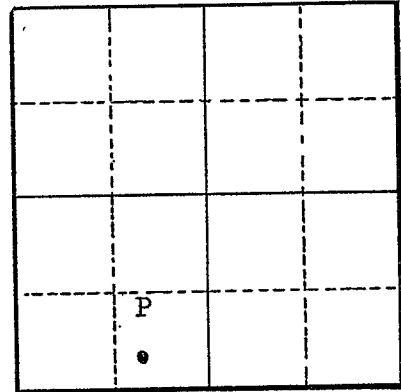

Altitude at well between 300 and 500

TYPE OF WELL: Drilled Date Constructed Aug. 15, 1954

Depth drilled 75 feet Depth cased 40 feet

Section 33

### CASING RECORD:

5-inch casing (standard block pipe) set from ground to 40 feet below

### FINISH:

### AQUIFERS:

clay and sandstone

### WATER LEVEL:

58 feet

PUMPING EQUIPMENT: Type 1 Horse Pamona H.P.  
Capacity \_\_\_\_\_ G.P.M.

### WELL TESTS:

Drawdown 7 ft. after \_\_\_\_\_ hours 33 1/3 G.P.M.  
Drawdown \_\_\_\_\_ ft. after \_\_\_\_\_ hours \_\_\_\_\_ G.P.M.

USE OF WATER Irrigation Temp. \_\_\_\_\_ °F., 19

SOURCE OF INFORMATION GR-4099

DRILLER or DIGGER Mark Christensen Eugene, Oregon

### ADDITIONAL DATA:

Log  Water Level Measurements \_\_\_\_\_ Chemical Analysis \_\_\_\_\_ Aquifer Test \_\_\_\_\_

### REMARKS:

top soil and black clay 0 feet 6 feet  
weathered sandstone 6 feet 36 feet  
unweathered sandstone 36 feet 75 feet