

STATE ENGINEER
Salem, Oregon

Well Record ~~LANE~~ STATE WELL NO. 17/5W-2C
COUNTY ~~LANE~~
12723 APPLICATION NO. GR-2319


MAILING
OWNER: Robert L. Foster and Helen M. Foster ADDRESS: Rt. 1, Box 52

CITY AND
LOCATION OF WELL: Owner's No. STATE: Junction City, Oregon

NE 1/4 NW 1/4 Sec. 2 T. 17 S. R. 5 W., W.M.

Bearing and distance from section or subdivision

corner 386.2' W. 5 1/4 cor. Sec. 35 T. 16 S., R. 5 W.

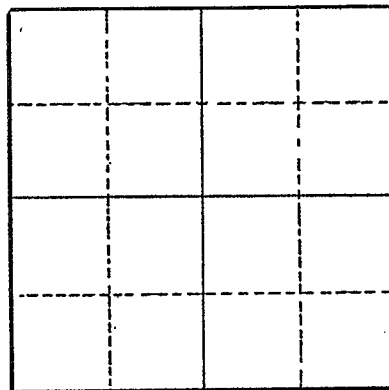

Section

Altitude at well

TYPE OF WELL: Drill Date Constructed 1955

Depth drilled 116 Depth cased 106

CASING RECORD:

8-inch

FINISH:

AQUIFERS:

WATER LEVEL:

86-feet

PUMPING EQUIPMENT: Type Pomona Turbine H.P. 3
Capacity 80 G.P.M.

WELL TESTS:

Drawdown ft. after hours G.P.M.

Drawdown ft. after hours G.P.M.

USE OF WATER Irrigation Temp. °F., 19

SOURCE OF INFORMATION GR-2208

DRILLER or DIGGER Curtis Miller, 1400 Cal Young Rd., Eugene, Oregon

ADDITIONAL DATA:

Log Water Level Measurements Chemical Analysis Aquifer Test

REMARKS: