

STATE ENGINEER  
Salem, Oregon

# Well Record


LANE STATE WELL NO. 17/5W-2D  
12741 COUNTY Lane  
APPLICATION NO. GR-2708

OWNER: Helen Bell Larson MAILING ADDRESS: 555 Buena Vista Avenue W.

LOCATION OF WELL: Owner's No. #2 CITY AND STATE: San Francisco 17, California

NW 1/4 NW 1/4 Sec. 2 T. 17 S, R. 5 W., W.M.

Bearing and distance from section or subdivision corner 2050 ft. E. & 360 ft. N. of SW corner James Watson DLC 47

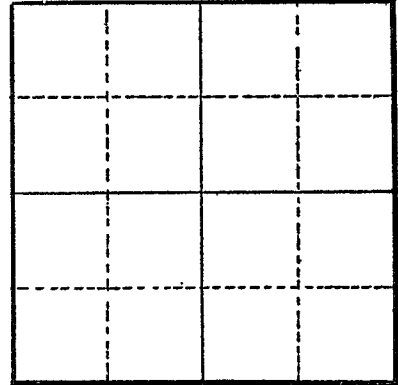

Section .....

Altitude at well .....

TYPE OF WELL: Driven Date Constructed 1946

Depth drilled 20 feet Depth cased 20 feet

CASING RECORD:  
4-inch intake

FINISH:  
Unknown from 17 to 20

AQUIFERS:

WATER LEVEL:  
15 feet

PUMPING EQUIPMENT: Type Cent 4" x 3" outlet H.P. 15  
Capacity 340 G.P.M.

WELL TESTS:  
Drawdown ..... ft. after ..... hours Pumping 340 G.P.M.  
Drawdown ..... ft. after ..... hours ..... G.P.M.

USE OF WATER Irrigation Temp. °F. 19

SOURCE OF INFORMATION GR-2857

DRILLER or DIGGER .....

ADDITIONAL DATA:  
Log ..... Water Level Measurements ..... Chemical Analysis ..... Aquifer Test .....

REMARKS: