

STATE ENGINEER
Salem, Oregon

Well Record **LANE**
12744

STATE WELL NO. 17/5W-2E
COUNTY Lane
APPLICATION NO. GR-3152

OWNER: Roy Croson


MAILING ADDRESS: Route 1, Box 76

LOCATION OF WELL: Owner's No.

CITY AND STATE: Junction City, Oregon

SW 1/4 NW 1/4 Sec. 2 T. 17 N S, R. 5 W, W.M.

Bearing and distance from section or subdivision corner 60' N.E. of 1/4 Cor. Sec. 3 and Sec. 2

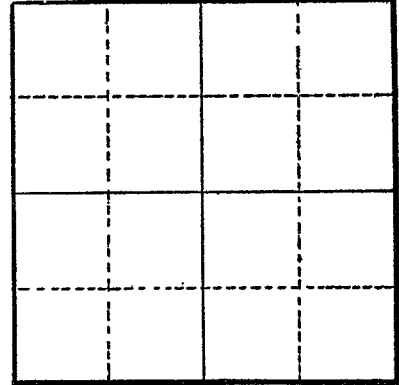

Section

Altitude at well

TYPE OF WELL: Drilled Date Constructed 1951

Depth drilled 78' Depth cased 78'

CASING RECORD:

5"

FINISH:

perforated from 50 to 78'

AQUIFERS:

WATER LEVEL:

20'

PUMPING EQUIPMENT: Type Myer Jet H.P. 1
Capacity G.P.M.

WELL TESTS:
Drawdown ft. after hours G.P.M.
Drawdown ft. after hours G.P.M.

USE OF WATER Irrigation Temp. °F. 19

SOURCE OF INFORMATION GR-2953 Col Young Rd

DRILLER or DIGGER Curtis Miller Well Drilling Co. 1400 Young Rd., Eugene, Oregon

ADDITIONAL DATA:

Log Water Level Measurements Chemical Analysis Aquifer Test

REMARKS: