


STATE ENGINEER
Salem, Oregon

Well Record **LANE** STATE WELL NO. 17/5W-3A
COUNTY Lane
12771 APPLICATION NO. GR-3340

OWNER: Vern Leroy Murphy
MAILING ADDRESS: P. O. Box 28
CITY AND STATE: Alvadore, Oregon

LOCATION OF WELL: Owner's No. _____
NE 1/4 NE 1/4 Sec. 3 T. 17 S., R. 5 W., W.M.

Bearing and distance from section or subdivision
corner 3400 feet West and 800 feet South from the
S 1/4 Corner, Section 35

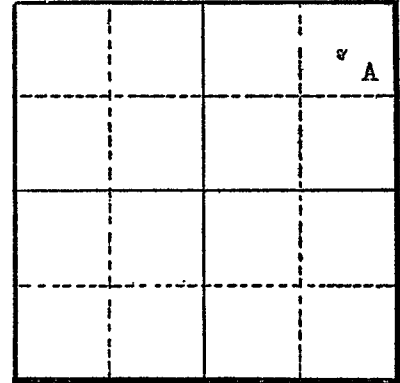

Section 3

Altitude at well 200 feet

TYPE OF WELL: drilled Date Constructed Aug. 5, 1950
Depth drilled 132 feet Depth cased 126 feet

CASING RECORD:

5-inch casing set from 0 to 126 feet

FINISH:

AQUIFERS:

WATER LEVEL:

8 feet

PUMPING EQUIPMENT: Type Dorward Deepth Well Jet H.P. _____
Capacity 30 G.P.M.

WELL TESTS:

Drawdown 60 ft. after _____ hours 4 G.P.M.
Drawdown _____ ft. after _____ hours _____ G.P.M.

USE OF WATER Irrigation Temp. _____ °F. _____, 19

SOURCE OF INFORMATION GR-4016

DRILLER or DIGGER Ed Odneal

ADDITIONAL DATA:

Log (NA) Water Level Measurements _____ Chemical Analysis _____ Aquifer Test _____

REMARKS: