



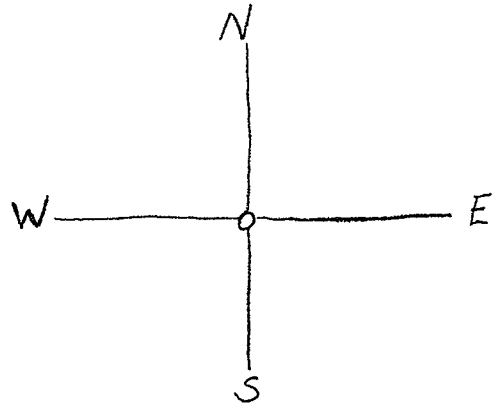

FERN RIDGE RESERVOIR  
LANE COUNTY, OREGON

OUTLEASE TO  
TRI-PASS SKI CLUB, INC.

D-FR-16

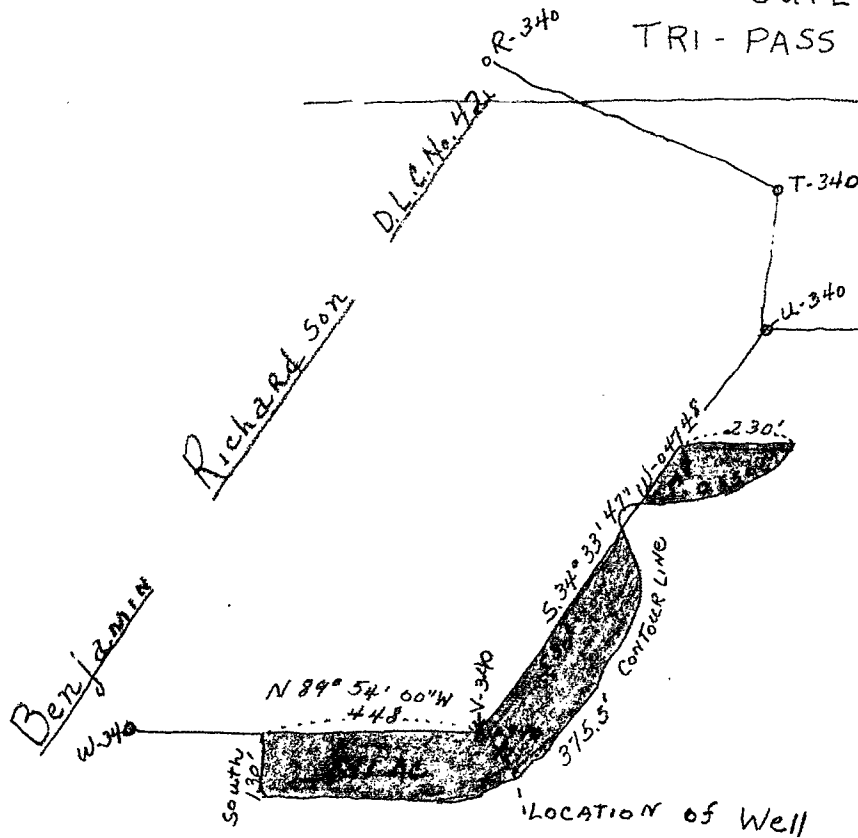

RECEIVED  
MAR 23 1961  
STATE ENGINEER  
SALEM, OREGON