

STATE ENGINEER
Salem, Oregon

4 ANE
Well Record

STATE WELL NO. 17/5W-13-K

COUNTY Lane

APPLICATION NO. GR-3132

OWNER: Philip B. Grenon

MAILING

ADDRESS: Route 1, Box 267

LOCATION OF WELL: Owner's No.

CITY AND

STATE: Eugene, Oregon

NW 1/4 SE 1/4 Sec. 13 T. 17 N. S. R. 5 E. W., W.M.

Bearing and distance from section or subdivision

corner 1380' W. and 1525' N.

Altitude at well

TYPE OF WELL: drilled Date Constructed 1950

Depth drilled 42' Depth cased 42'

CASING RECORD:

4"

FINISH:

AQUIFERS:

WATER LEVEL:

2'

PUMPING EQUIPMENT: Type Jacuzzi Multi-stage 1 1/2 x 1 H.P. 1
Capacity 48 G.P.M.

WELL TESTS:

Drawdown ft. after hours G.P.M.

Drawdown ft. after hours G.P.M.

USE OF WATER Irrigation Temp. °F., 19


SOURCE OF INFORMATION GR-3175

DRILLER or DIGGER Ben Preston

ADDITIONAL DATA:

Log Water Level Measurements Chemical Analysis Aquifer Test

REMARKS:

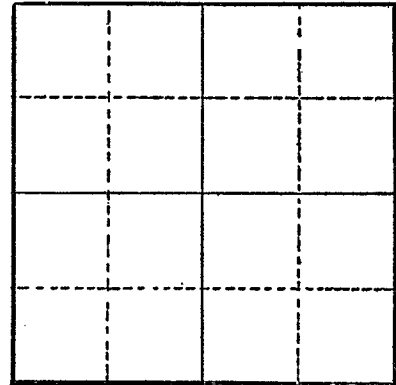

Section