

STATE ENGINEER
Salem, Oregon

Well Record

LANE
1326

STATE WELL NO. 17/5W-25A & E
COUNTY Lane
APPLICATION NO. GR-2694

OWNER: Estate of Irene Verne Miller

MAILING

ADDRESS: 7540 Royal Avenue

LOCATION OF WELL: Owner's No.

CITY AND

STATE: Eugene, Oregon

NE $\frac{1}{4}$ NE $\frac{1}{4}$ NW $\frac{1}{4}$ NE $\frac{1}{4}$ Sec. 25 T. 17 S., R. 5 W., W.M.


Bearing and distance from section or subdivision

corner 1383' - S 77° 15' W. of N.E. Cor., Sec. 25

Altitude at well

TYPE OF WELL: Drilled Date Constructed 1952

Depth drilled 168' Depth cased 42'

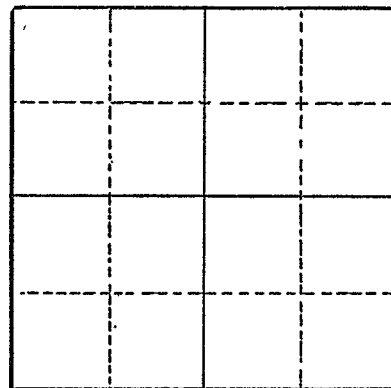

Section

CASING RECORD:

6 inch

FINISH:

AQUIFERS:

WATER LEVEL:

12 feet

PUMPING EQUIPMENT: Type Johnson Pump H.P. 2
Capacity 80 G.P.M.

WELL TESTS:

Drawdown 40 ft. after hours pumping 80 G.P.M.

Drawdown ft. after hours G.P.M.

USE OF WATER irrigation Temp. °F. 19

SOURCE OF INFORMATION GR-2552

DRILLER or DIGGER Elvin Denge

ADDITIONAL DATA:

Log Water Level Measurements Chemical Analysis Aquifer Test

REMARKS: