

STATE ENGINEER
Salem, Oregon

Well Record

LANE STATE WELL NO. 17/5W-29H
COUNTY *LANE*
13416 APPLICATION NO. GR-3085

OWNER: Gaile H. Goud


MAILING ADDRESS: Rt 2, Box 293

LOCATION OF WELL: Owner's No.

CITY AND STATE: Veneta, Oregon

SE 1/4 NE 1/4 Sec. 29 T. 17 S., R. 5 W., W.M.

Bearing and distance from section or subdivision corner 440' N & 1050' W from E 1/4 cor Sec 29

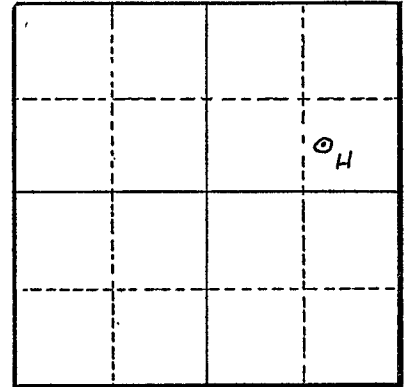

Section 29

Altitude at well

TYPE OF WELL: Drilled Date Constructed

Depth drilled 33' Depth cased 33'

CASING RECORD:

6-inch

FINISH:

Perforated about 8 Per Ft 6" to 33'

AQUIFERS:

Red sand & loam, clay, fine gravel

WATER LEVEL:

20'

PUMPING EQUIPMENT: Type Centrifugal

H.P. 9

Capacity 50 G.P.M.

WELL TESTS:

Drawdown 5 ft. after 25 hours G.P.M.

Drawdown ft. after hours G.P.M.

USE OF WATER Garden & Nursery stock Temp. °F., 19

SOURCE OF INFORMATION GR-3920

DRILLER or DIGGER

ADDITIONAL DATA:

Log Water Level Measurements Chemical Analysis Aquifer Test

REMARKS:

Red sand & loam	2'	to	2'
Red sand & clay	17'	to	19'
Sand & fine gravel	14'	to	33'