

STATE ENGINEER
Salem, Oregon

Well Record **LANE** STATE WELL NO. 17/5W-29M
13417 COUNTY Lane APPLICATION NO. GR-905

OWNER: D. M. Carmony


MAILING ADDRESS: FED. L. Box 219

LOCATION OF WELL: Owner's No.

CITY AND STATE: Veneta, Oregon

NW 1/4 SW 1/4 Sec. 29 T. 17 N. S. R. 5 W., W.M.

Bearing and distance from section or subdivision corner 14.24 rds. E. of 1/4 cor. & 7 rds. S. of 1/4 line

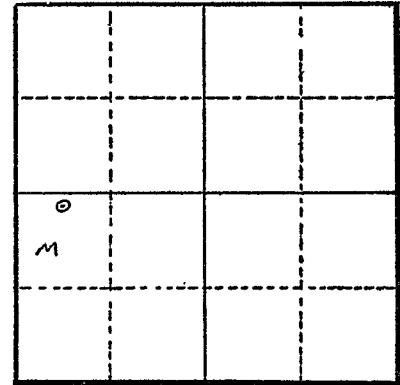

Altitude at well 280 ft.

TYPE OF WELL: drilled Date Constructed June 1954

Depth drilled 68 ft. Depth cased

Section 29

CASING RECORD: 4 inch 0 - 68 ft.

FINISH:

AQUIFERS:

WATER LEVEL: 27 ft.

PUMPING EQUIPMENT: Type H.P.
Capacity G.P.M.

WELL TESTS:
Drawdown 10 ft. after hours use G.P.M.
Drawdown ft. after hours G.P.M.

USE OF WATER irrigation Temp. °F., 19

SOURCE OF INFORMATION owner
DRILLER or DIGGER C. D. Cook

ADDITIONAL DATA:
Log Water Level Measurements Chemical Analysis Aquifer Test

REMARKS: