

STATE ENGINEER  
Salem, Oregon

# Well Record


LANE  
13544

STATE WELL NO. 17/5W-31H  
COUNTY Lane  
APPLICATION NO. GR-3902

OWNER: Fredrick E. Hess  
MAILING ADDRESS: Route 2, Box 103  
CITY AND STATE: Veneta, Oregon

LOCATION OF WELL: Owner's No. SE 1/4 NE 1/4 Sec. 31 T. 17 S. R. 5 W., W.M.

Bearing and distance from section or subdivision corner 338' N.E. in NE cor. of SE 1/4 NE 1/4 or E 1/4 Cor. to S.W. Cor. of 2 acre plot

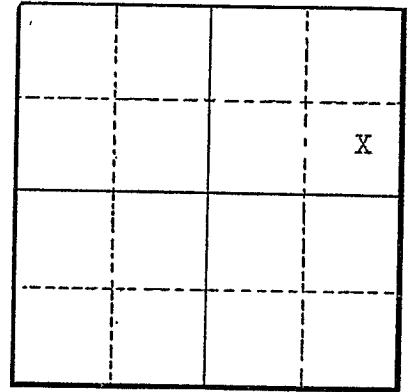

Section 31

Altitude at well

TYPE OF WELL: Drilled Date Constructed 4/1946

Depth drilled 86 ft. Depth cased 86 ft.

### CASING RECORD:

6 inch casing set to 86 feet

### FINISH:

one inch perforation, four per foot from 76 to 86 feet

### AQUIFERS:

### WATER LEVEL:

23 feet below surface

PUMPING EQUIPMENT: Type Layne Bowlin turbine H.P. 5  
Capacity G.P.M.

### WELL TESTS:

Drawdown ft. after hours G.P.M.  
Drawdown ft. after hours G.P.M.

USE OF WATER Irrigation Temp. °F., 19

SOURCE OF INFORMATION Well Registration Statement Cert. #GR-3545  
DRILLER or DIGGER P.M. Cook

### ADDITIONAL DATA:

Log Water Level Measurements Chemical Analysis Aquifer Test

### REMARKS: