

STATE ENGINEER
Salem, Oregon

Well Record

LANE STATE WELL NO. 17/5W-31K
1351 COUNTY Lane
APPLICATION NO. GR-3873

OWNER: John Loren Baker


MAILING ADDRESS: Route 2, Box 178

LOCATION OF WELL: Owner's No. _____

CITY AND STATE: Veneta, Oregon

NW $\frac{1}{4}$ SE $\frac{1}{4}$ Sec. 31 T. 17 S., R. 5 W., W.M.

Bearing and distance from section or subdivision corner 1490' W. & 145' S. from E $\frac{1}{4}$ Cor. Sec. 31

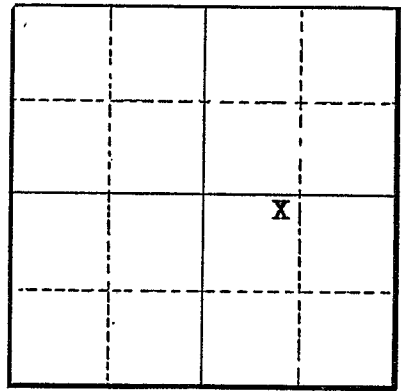

Section 31

Altitude at well _____

TYPE OF WELL: Drilled Date Constructed prior 1955

Depth drilled 81 feet Depth cased _____

CASING RECORD:

FINISH:

AQUIFERS:

WATER LEVEL:

PUMPING EQUIPMENT: Type Fairbanks Morse H.P. 1 $\frac{1}{2}$
Capacity 25 G.P.M.

WELL TESTS:
Drawdown _____ ft. after _____ hours _____ G.P.M.
Drawdown _____ ft. after _____ hours _____ G.P.M.

USE OF WATER Irrigation Temp. _____ °F. _____, 19

SOURCE OF INFORMATION Well Registration Statement Cert. # GR-3523

DRILLER or DIGGER Wayne Hayes

ADDITIONAL DATA:
Log _____ Water Level Measurements _____ Chemical Analysis _____ Aquifer Test _____

REMARKS: