

STATE ENGINEER
Salem, Oregon

Well Record **LANE** STATE WELL NO. 17/6W-24K
COUNTY **LANE**
14158 APPLICATION NO. GR-3695

OWNER: Fred L. Meek

MAILING ADDRESS: Box No. 18


LOCATION OF WELL: Owner's No.

CITY AND STATE: Elmira, Oregon

NW 1/4 SE 1/4 Sec. 24 T. 17 S., R. 6 W., W.M.

Bearing and distance from section or subdivision

corner 1900' W & 860' S from E Cor Sec 24

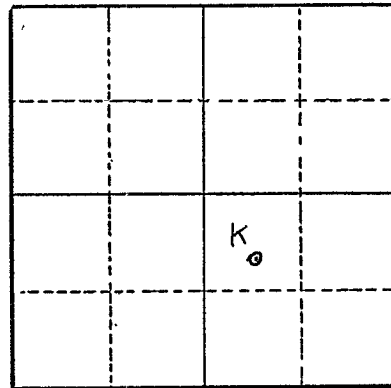

Section 24

Altitude at well

TYPE OF WELL: Drilled Date Constructed 1953

Depth drilled 120' Depth cased 85

CASING RECORD:

FINISH:

AQUIFERS:

WATER LEVEL: 25'

PUMPING EQUIPMENT: Type Fairbanks Morse H.P. 1
Capacity 10 G.P.M.

WELL TESTS:
Drawdown 60.80 ft. after hours 900 G.P.M.
Drawdown ft. after hours G.P.M.

USE OF WATER Irrigation Temp. °F. 19
SOURCE OF INFORMATION GR-3943
DRILLER or DIGGER Wayne Hayes

ADDITIONAL DATA:
Log NA Water Level Measurements Chemical Analysis Aquifer Test

REMARKS: