

STATE ENGINEER  
Salem, Oregon

Well Record ~~LANE~~ 14289  
STATE WELL NO. 17/6N-26N  
COUNTY ~~LANE~~  
APPLICATION NO. GR-2604

OWNER: Kenneth E. & Cora J. Graighill


MAILING ADDRESS: Rt. 1, Box 350

LOCATION OF WELL: Owner's No.

CITY AND STATE: Veneta, Oregon

SW  $\frac{1}{4}$  SW  $\frac{1}{4}$  Sec. 26 T. 17 N. S. R. 6 E. W.M.

Bearing and distance from section or subdivision corner 840' N. and 50' E.

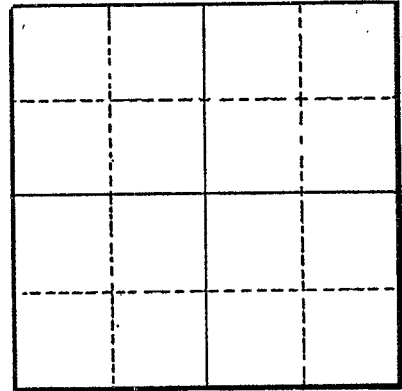

Altitude at well

TYPE OF WELL: Drilled Date Constructed 1949

Depth drilled 59 Depth cased 40 ?

Section

CASING RECORD:

6-inch

FINISH:

AQUIFERS:

WATER LEVEL:  
15-feet

PUMPING EQUIPMENT: Type Westinghouse Centrifugal H.P. 2  
Capacity 120 G.P.M.

WELL TESTS:

Drawdown ft. after hours G.P.M.  
Drawdown ft. after hours G.P.M.

USE OF WATER Irrigation Temp. °F. 19

SOURCE OF INFORMATION GR-2471

DRILLER or DIGGER

ADDITIONAL DATA:

Log Water Level Measurements Chemical Analysis Aquifer Test

REMARKS: