

STATE ENGINEER  
Salem, Oregon


Well Record **LANE** STATE WELL NO. 17/6W-36H  
1447 COUNTY Lane  
APPLICATION NO. GR-3590

OWNER: Edwin H. Guilford MAILING ADDRESS: Route 1, Box 997

LOCATION OF WELL: Owner's No. CITY AND STATE: Veneta, Oregon

SE 1/4 NE 1/4 Sec. 36 T. 17 N. S. R. 6 E. W., W.M.

Bearing and distance from section or subdivision corner 1560 feet South and 960 feet West from NE Corner, Section 36; being within Lot 3, Block 3

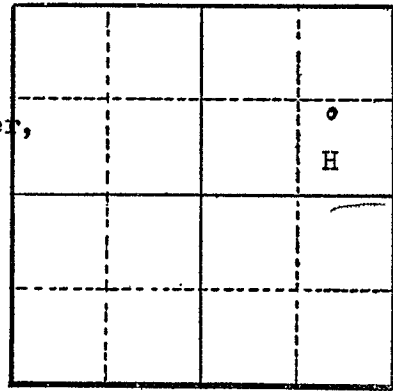

Section 36

Altitude at well

TYPE OF WELL: Drilled Date Constructed 1940

Depth drilled 95 feet Depth cased 50

CASING RECORD:  
2 (6-inch) casing set from 0 to 50 feet

FINISH:

AQUIFERS:

WATER LEVEL:  
80 feet

PUMPING EQUIPMENT: Type Myers (Ejecto) Pump H.P. 10  
Capacity 5000 gph G.P.M.

WELL TESTS:  
Drawdown ft. after hours G.P.M.  
Drawdown ft. after hours G.P.M.

USE OF WATER Industrial Temp. °F. 19

SOURCE OF INFORMATION GR-4037

DRILLER or DIGGER

ADDITIONAL DATA:  
Log (NA) Water Level Measurements Chemical Analysis Aquifer Test

REMARKS: