

STATE ENGINEER
Salem, Oregon


Well Record **LANE** STATE WELL NO. 17/1-1P
COUNTY **LANE**
14722 APPLICATION NO. GR-2339

OWNER: Albert W. and or Nettie Wooley MAILING ADDRESS: Leaburg, Oregon
CITY AND STATE:

LOCATION OF WELL: Owner's No. _____

SE 1/4 SW 1/4 Sec. 1 T. 17 S., R. 1 W., W.M.

Bearing and distance from section or subdivision
corner 290' N. and 1390' E.

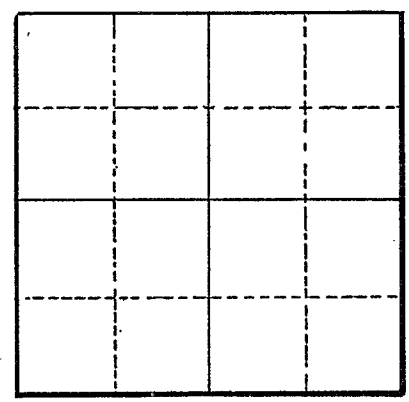

Section _____

Altitude at well _____

TYPE OF WELL: Dug Date Constructed 1938

Depth drilled 14 Depth cased 14

CASING RECORD:

48-inch

FINISH:

AQUIFERS:

WATER LEVEL:

8-feet

PUMPING EQUIPMENT: Type Demming Centrifugal H.P. 7 1/2
Capacity 100 G.P.M.

WELL TESTS:

Drawdown _____ ft. after _____ hours _____ G.P.M.
Drawdown _____ ft. after _____ hours _____ G.P.M.

USE OF WATER Irrigation Temp. _____ °F., 19

SOURCE OF INFORMATION GR-2223

DRILLER or DIGGER

ADDITIONAL DATA:

Log _____ Water Level Measurements _____ Chemical Analysis _____ Aquifer Test _____

REMARKS: