

STATE ENGINEER
Salem, Oregon

Well Record **LANE**

STATE WELL NO. 17/1-19C(1)
COUNTY Lane
APPLICATION NO. 6-1725

14888

OWNER: Richard & Ivy Hart


MAILING ADDRESS: 15710 McKenzie Hwy.

LOCATION OF WELL: Owner's No. #1

CITY AND STATE: Springfield, Oregon

NE 1/4 NW 1/4 Sec. 19 T. 17 S., R. 1 E., W.M.

Bearing and distance from section or subdivision corner 670' N. & 459' W. from SE cor. of NE 1/4 of NW 1/4 of section 19.

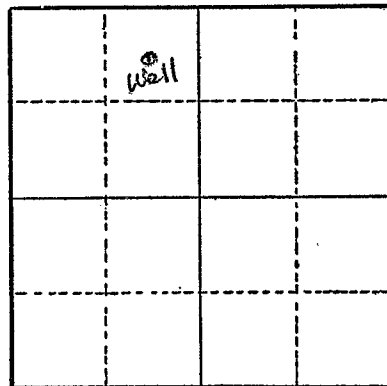

Section 19

Altitude at well _____

TYPE OF WELL: Dug Date Constructed 1948

Depth drilled 10 ft. Depth cased 8 ft.

CASING RECORD:

72x72 inch from 0 to 8 ft.

FINISH:

AQUIFERS:

WATER LEVEL:

6 ft.

PUMPING EQUIPMENT: Type Pacific cent. 5x7 H.P. 20
Capacity _____ G.P.M.

WELL TESTS:

Drawdown _____ ft. after _____ hours _____ G.P.M.

Drawdown _____ ft. after _____ hours _____ G.P.M.

USE OF WATER Irrigation & stock Temp. _____ °F., 19____

SOURCE OF INFORMATION Belated registration statement

DRILLER or DIGGER Owner

ADDITIONAL DATA:

Log _____ Water Level Measurements _____ Chemical Analysis _____ Aquifer Test _____

REMARKS: