

STATE ENGINEER
Salem, Oregon


Well Record **LANE**

STATE WELL NO. 18/2W-5K
COUNTY Lane
APPLICATION NO. GR-3580

15279

OWNER: T. F. Tryon
LOCATION OF WELL: Owner's No. _____
MAILING ADDRESS: Route 1, Box 362
CITY AND STATE: Springfield, Oregon

NW $\frac{1}{4}$ SE $\frac{1}{4}$ Sec. 5 T. 18 S., R. 2 W., W.M.
Bearing and distance from section or subdivision
corner 3078.39 N. 42° 12' E. from the SW corner
of David L. Arthur D.L.C. #83

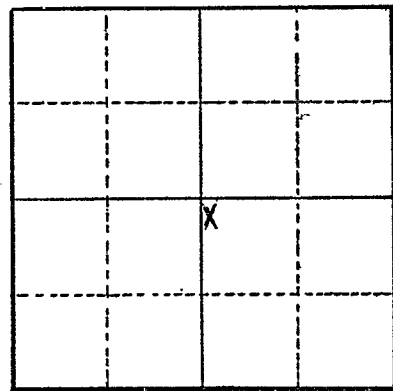

Section 5

Altitude at well _____
TYPE OF WELL: Dug Date Constructed 1948
Depth drilled 8 ft. Depth cased _____

CASING RECORD:

FINISH:

AQUIFERS:

WATER LEVEL:

6 feet from surface

PUMPING EQUIPMENT: Type Palmer Lift fan type size - 4 in. H.P. 18
Capacity _____ G.P.M.

WELL TESTS:

Drawdown 3 ft. after _____ hours _____ G.P.M.
Drawdown _____ ft. after _____ hours _____ G.P.M.

USE OF WATER Irrigation Temp. _____ °F., 19 _____

SOURCE OF INFORMATION Well Registration Statement

DRILLER or DIGGER _____

ADDITIONAL DATA:

Log X Water Level Measurements _____ Chemical Analysis _____ Aquifer Test _____

REMARKS:

Log:
No material just gravel and rock