

STATE ENGINEER  
Salem, Oregon

Well Record **LANE** STATE WELL NO. 18/2W-5.J  
15781 COUNTY LANE  
APPLICATION NO. GR-3585

OWNER: R. J. Wright


MAILING ADDRESS: Rt 1 Box 353

LOCATION OF WELL: Owner's No.

CITY AND STATE: Springfield, Ore

NE 1/4 SE 1/4 Sec. 5 T. 18 S., R. 2 W., W.M.

Bearing and distance from section or subdivision  
corner 2712' E & 1290' N of the SW cor of DLC #63

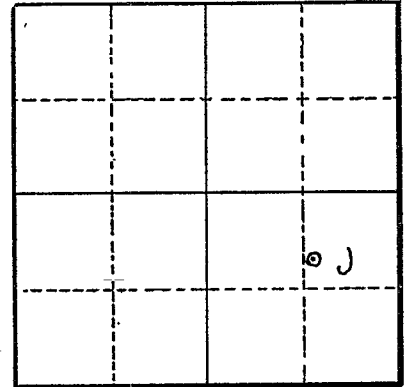

Section 5

Altitude at well

TYPE OF WELL: Dug Date Constructed 1940

Depth drilled 25' Depth cased

CASING RECORD:

FINISH:

AQUIFERS: sandy loam, river gravel

WATER LEVEL:

8'

PUMPING EQUIPMENT: Type Centrifugal Pump H.P. 5  
Capacity 200 G.P.M.

WELL TESTS:

Drawdown ft. after hours G.P.M.  
Drawdown ft. after hours G.P.M.

USE OF WATER Irrigation Temp. °F., 19

SOURCE OF INFORMATION GR-3977

DRILLER or DIGGER

ADDITIONAL DATA:

Log  Water Level Measurements Chemical Analysis Aquifer Test

REMARKS:

sandy loam 0' to 4'  
River gravel 4' to 25'