

STATE ENGINEER
Salem, Oregon

Well Record **LANE** STATE WELL NO. 18/2W-5R
15284 COUNTY Lane
APPLICATION NO. GR-3946

OWNER: Clyde A. Keever MAILING ADDRESS: Route 1, Box 351

LOCATION OF WELL: Owner's No. CITY AND STATE: Springfield, Oregon


SE 1/4 SE 1/4 Sec. 5 T. 18 S., R. 2 W., W.M.

Bearing and distance from section or subdivision corner 1350' 285° from SE Cor. Sec. 5

Altitude at well

TYPE OF WELL: Driven Date Constructed

Depth drilled 20 ft. Depth cased 20 ft.

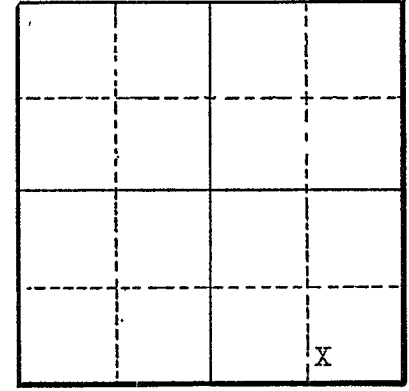

Section 5

CASING RECORD:

4 inch iron pipe driven to about 20 feet

FINISH:

AQUIFERS:

WATER LEVEL:

10 feet below surface

PUMPING EQUIPMENT: Type portable H.P.
Capacity G.P.M.

WELL TESTS:

Drawdown ft. after hours G.P.M.
Drawdown ft. after hours G.P.M.

USE OF WATER Irrigation Temp. °F., 19
SOURCE OF INFORMATION Well Registration Statement Cert. # GR-3576

DRILLER or DIGGER

ADDITIONAL DATA:

Log Water Level Measurements Chemical Analysis Aquifer Test

REMARKS: