


STATE ENGINEER  
Salem, Oregon

Well Record **LANE** STATE WELL NO. 18/2W-6A  
15299 COUNTY Lane  
APPLICATION NO. GR-3970

OWNER: William Thomas Mills and/or Neva I. Mills MAILING ADDRESS: Route 1, Box 392  
CITY AND STATE: Springfield, Oregon

LOCATION OF WELL: Owner's No. \_\_\_\_\_  
NE 1/4 NE 1/4 Sec. 6 T. 18 S. R. 2 W., W.M.  
Bearing and distance from section or subdivision  
corner 1113 feet South of intersection corners  
of Sections 31, 32, 6, and 5 thence West  
approximately 300 feet

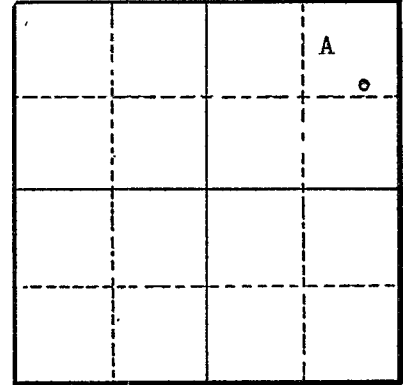

Section 6

Altitude at well 500 feet

TYPE OF WELL: Drilled Date Constructed 51 or 52  
Depth drilled 38 feet Depth cased 38 feet

CASING RECORD:

5-inch casing set from 0 to 38 feet

FINISH:

18 3/8 x 4 from 31 to 38 feet

AQUIFERS:

sand and gravel

WATER LEVEL:

30 feet

PUMPING EQUIPMENT: Type 5H Jaquzzi Centrifical H.P. \_\_\_\_\_  
Capacity 100 G.P.M.

WELL TESTS:

Drawdown \_\_\_\_\_ ft. after \_\_\_\_\_ hours \_\_\_\_\_ G.P.M.  
Drawdown \_\_\_\_\_ ft. after \_\_\_\_\_ hours \_\_\_\_\_ G.P.M.

USE OF WATER Irrigation Temp. \_\_\_\_\_ °F. \_\_\_\_\_, 19

SOURCE OF INFORMATION GR-4071

DRILLER or DIGGER Carter Well Drillers Springfield, Oregon

ADDITIONAL DATA:

Log  Water Level Measurements \_\_\_\_\_ Chemical Analysis \_\_\_\_\_ Aquifer Test \_\_\_\_\_

REMARKS:

top soil 6 feet  
sand and gravel 6 feet 38 feet