

STATE ENGINEER
Salem, Oregon

Well Record **LANE** STATE WELL NO. 18/2W-6G
COUNTY Lane APPLICATION NO. GR-1385
GR-1342 /5305

OWNER: Fred Hills


MAILING ADDRESS: Rt. 1, Box 421

LOCATION OF WELL: Owner's No. #1

CITY AND STATE: Springfield, Oregon

SW ¼ NE ¼ Sec. 6 T. 18 S., R. 2 W., W.M.

Bearing and distance from section or subdivision corner 380' N. & 1420' W. from E¼ cor. Sec. 6

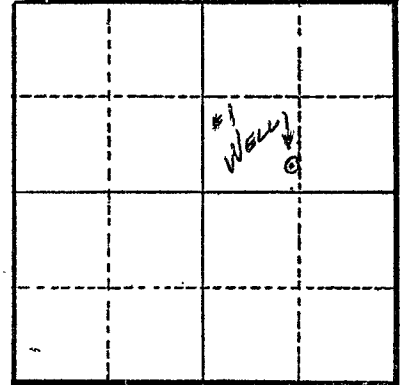

Altitude at well 500 ft.

TYPE OF WELL: Drilled Date Constructed 1943

Depth drilled 16 ft. Depth cased 16 ft. Section 6

CASING RECORD:
12 inch

FINISH:
Perforated from 12 to 16 ft.

AQUIFERS:

WATER LEVEL:
8 ft.

PUMPING EQUIPMENT: Type F. M. 2 in. Cent. H.P. 7½
Capacity 350 G.P.M.

WELL TESTS:
Drawdown 6 ft. after 350 hours G.P.M.
Drawdown ft. after hours G.P.M.

USE OF WATER Irrigation Temp. °F., 19

SOURCE OF INFORMATION G. R. Record

DRILLER or DIGGER

ADDITIONAL DATA:

Log Water Level Measurements Chemical Analysis Aquifer Test

REMARKS:

Log: Top soil, loam 0 to 4 ft.
Sand 4 to 10 ft.
Gravel 10 to 12 ft.

Irrigation of 3 acres.