


STATE ENGINEER  
Salem, Oregon

Well Record **LANE** STATE WELL NO. 18/2W-6H(1)  
15306 COUNTY Lane  
GR- 1136 APPLICATION NO. GR- 1175

OWNER: Edward W. & Martha E. McBee  
MAILING ADDRESS: Rt. 1, Box 414  
CITY AND STATE: Springfield, Oregon

LOCATION OF WELL: Owner's No. \_\_\_\_\_  
SE 1/4 NE 1/4 Sec. 6 T. 18 S., R. 2 W., W.M.  
Bearing and distance from section or subdivision  
corner 3265' S. 31° W. of NE cor. of the Jr. Magness  
DLC. #50.

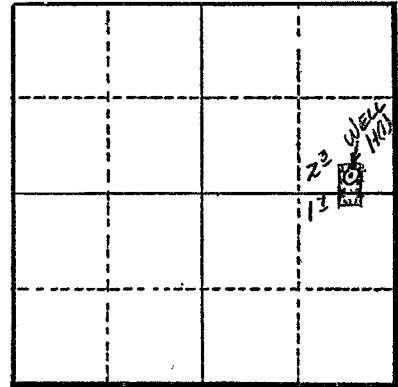

Section 6

Altitude at well 425 ft.

TYPE OF WELL: Driven Date Constructed 1947  
Depth drilled 22 ft. Depth cased 22 ft.

CASING RECORD:  
2 inch

FINISH:

AQUIFERS:

WATER LEVEL:  
8 ft.

PUMPING EQUIPMENT: Type Pacific 1 1/2 in. Cent. H.P. 2  
Capacity 60 G.P.M.

WELL TESTS:  
Drawdown \_\_\_\_\_ ft. after \_\_\_\_\_ hours \_\_\_\_\_ G.P.M.  
Drawdown \_\_\_\_\_ ft. after \_\_\_\_\_ hours \_\_\_\_\_ G.P.M.

USE OF WATER Irrigation Temp. \_\_\_\_\_ °F., 19

SOURCE OF INFORMATION G. R. Record

DRILLER or DIGGER \_\_\_\_\_

ADDITIONAL DATA:  
Log \_\_\_\_\_ Water Level Measurements \_\_\_\_\_ Chemical Analysis \_\_\_\_\_ Aquifer Test \_\_\_\_\_

REMARKS:

Log: Silty loam 0 to 10 ft.  
Sand & gravel 10 to 22 ft.

Irrigation of 4 acres.