

STATE ENGINEER
Salem, Oregon

Well Record **LANE** STATE WELL NO. 18/2W-4,8A
COUNTY LANE
15319 APPLICATION NO. GR-2753

OWNER: Elizabeth Clearwater

MAILING ADDRESS: Rt. 1, Box 367


LOCATION OF WELL: Owner's No. _____

CITY AND STATE: Springfield, Oregon

NE $\frac{1}{4}$ NE $\frac{1}{4}$ Sec. 48 T. 18 N S., R. 2 E W., W.M.

Bearing and distance from section or subdivision

corner 60' S. and 30' W.

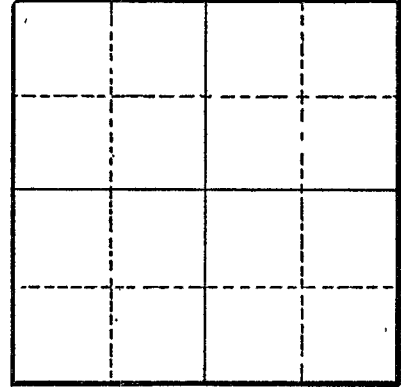

Section _____

Altitude at well _____

TYPE OF WELL: driven Date Constructed 1941

Depth drilled 21 Depth cased 21

CASING RECORD:

4-inch

FINISH:

Drill holes from 18 to 21

AQUIFERS:

WATER LEVEL:

14-feet

PUMPING EQUIPMENT: Type Fairbanks Morse Centrifugal H.P. _____
Capacity 300 G.P.M.

WELL TESTS:

Drawdown _____ ft. after _____ hours _____ G.P.M.

Drawdown _____ ft. after _____ hours _____ G.P.M.

USE OF WATER Irrigation Temp. _____ °F. _____, 19____

SOURCE OF INFORMATION GR-2603

DRILLER or DIGGER _____

ADDITIONAL DATA:

Log _____ Water Level Measurements _____ Chemical Analysis _____ Aquifer Test _____

REMARKS: