

STATE ENGINEER  
Salem, Oregon

# Well Record

LANE  
15452

STATE WELL NO. 18/2W-18N  
COUNTY Lane  
APPLICATION NO. GR-3547

OWNER: Kenneth Hulse


MAILING ADDRESS: Route 4, Box 133

LOCATION OF WELL: Owner's No. \_\_\_\_\_

CITY AND STATE: Oregon

SW 1/4 SW 1/4 Sec. 18 T. 18 <sup>N.</sup> S., R. 2 <sup>E.</sup> W., W.M.

Bearing and distance from section or subdivision  
corner 900 feet North and 500 feet East of the  
SW Corner, Section 18

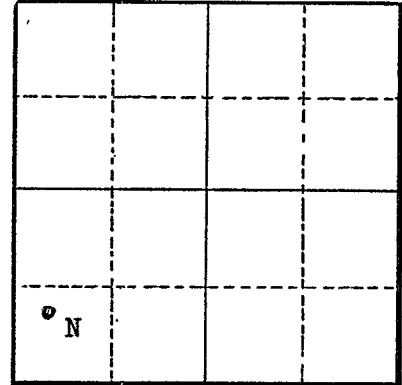

Section 18

Altitude at well \_\_\_\_\_

TYPE OF WELL: Drilled Date Constructed 1950

Depth drilled 20 feet Depth cased 20 feet

CASING RECORD:

4-inch casing set from 0 to 20 feet

FINISH:

1/2" hole perforations 4 per foot from 16 to 20 feet

AQUIFERS:

gravel

WATER LEVEL:

10 feet

PUMPING EQUIPMENT: Type American Merser Centrifugal 3" suction H.P. \_\_\_\_\_  
Capacity 200 to 400 G.P.M.

WELL TESTS:

Drawdown 4 ft. after \_\_\_\_\_ hours 500 G.P.M.

Drawdown \_\_\_\_\_ ft. after \_\_\_\_\_ hours \_\_\_\_\_ G.P.M.

USE OF WATER Irrigation Temp. \_\_\_\_\_ °F. \_\_\_\_\_, 19\_\_\_\_

SOURCE OF INFORMATION GR-4089

DRILLER or DIGGER \_\_\_\_\_

ADDITIONAL DATA:

Log X Water Level Measurements \_\_\_\_\_ Chemical Analysis \_\_\_\_\_ Aquifer Test \_\_\_\_\_

REMARKS:

It is River Bottom and after 6' or 8' rest <sup>is</sup> ~~to~~ gravels/