

STATE ENGINEER
Salem, Oregon

Well Record ^{LANE}
¹⁵⁴⁵³ STATE WELL NO. 18/2W-18N
COUNTY Lane
APPLICATION NO. GR-4277

OWNER: Lawrence Bailey MAILING ADDRESS: Route 4, Box 134

LOCATION OF WELL: Owner's No. CITY AND STATE: Eugene, Oregon


SW $\frac{1}{4}$ SW $\frac{1}{4}$ Sec. 18 T. 18 ^{N.} S., R. 2 ^{E.} W., W.M.

Bearing and distance from section or subdivision corner 760 feet North and 210 feet East of the SW Corner, Section 18

Altitude at well 400 feet

TYPE OF WELL: Drilled Date Constructed June 1945

Depth drilled 19 feet Depth cased 19 feet

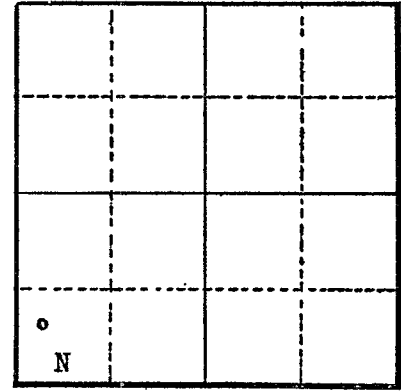

CASING RECORD:

2 1/2-inch pipe casing set from 0 to 19 feet

FINISH:

AQUIFERS:

sand and gravel

WATER LEVEL:

10 feet

PUMPING EQUIPMENT: Type Fairbanks Morse Cent. 2 in. H.P. _____
Capacity 150 G.P.M.

WELL TESTS:

Drawdown _____ ft. after _____ hours _____ G.P.M.
Drawdown _____ ft. after _____ hours _____ G.P.M.

USE OF WATER Irrigation Temp. _____ °F., 19.

SOURCE OF INFORMATION GR-4129

DRILLER or DIGGER Lawrence Bailey, owner

ADDITIONAL DATA:

Log (NA) Water Level Measurements _____ Chemical Analysis _____ Aquifer Test _____

REMARKS: